



**DEPARTMENT OF PERMITTING, ENVIRONMENT, AND REGULATORY  
AFFAIRS (PERA)  
BOARD AND CODE ADMINISTRATION DIVISION  
NOTICE OF ACCEPTANCE (NOA)**

**MIAMI-DADE COUNTY  
PRODUCT CONTROL SECTION**  
11805 SW 26 Street, Room 208  
Miami, Florida 33175-2474  
T (786) 315-2590 F (786) 315-2599  
[www.miamidade.gov/pera/](http://www.miamidade.gov/pera/)

**Sun-Tek Manufacturing, Inc.**  
**10303 General Drive**  
**Orlando, FL 32824**

**SCOPE:**

This NOA is being issued under the applicable rules and regulations governing the use of construction materials. The documentation submitted has been reviewed and accepted by Miami-Dade County PERA-Product Control Section to be used in Miami Dade County and other areas where allowed by the Authority Having Jurisdiction (AHJ).

This NOA shall not be valid after the expiration date stated below. The Miami-Dade County Product Control Section (In Miami Dade County) and/or the AHJ (in areas other than Miami Dade County) reserve the right to have this product or material tested for quality assurance purposes. If this product or material fails to perform in the accepted manner, the manufacturer will incur the expense of such testing and the AHJ may immediately revoke, modify, or suspend the use of such product or material within their jurisdiction. PERA reserves the right to revoke this acceptance, if it is determined by Miami-Dade County Product Control Section that this product or material fails to meet the requirements of the applicable building code.

This product is approved as described herein, and has been designed to comply with the Florida Building Code, including the High Velocity Hurricane Zone.

**DESCRIPTION: Model CMA-D Aluminum Skylight**

**APPROVAL DOCUMENT:** Drawing No. **CMA-D-004**, titled "CMA-D", sheets 1 and 2 of 2, dated 05/22/2000, prepared by the manufacturer, signed and sealed by James D. Wells, Jr., P.E., bearing the Miami-Dade County Product Control revision stamp with the Notice of Acceptance number and expiration date by the Miami-Dade County Product Control Section.

**MISSILE IMPACT RATING: Large and Small Missile Impact Resistant**

**LABELING:** Each unit shall bear a permanent label with the manufacturer's name or logo, city, state, model/series and following statement: "Miami-Dade County Product Control Approved", unless otherwise noted herein.

**RENEWAL** of this NOA shall be considered after a renewal application has been filed and there has been no change in the applicable building code negatively affecting the performance of this product.

**TERMINATION** of this NOA will occur after the expiration date or if there has been a revision or change in the materials, use, and/or manufacture of the product or process. Misuse of this NOA as an endorsement of any product, for sales, advertising or any other purposes shall automatically terminate this NOA. Failure to comply with any section of this NOA shall be cause for termination and removal of NOA.

**ADVERTISEMENT:** The NOA number preceded by the words Miami-Dade County, Florida, and followed by the expiration date may be displayed in advertising literature. If any portion of the NOA is displayed, then it shall be done in its entirety.

**INSPECTION:** A copy of this entire NOA shall be provided to the user by the manufacturer or its distributors and shall be available for inspection at the job site at the request of the Building Official.

This NOA revises NOA # 11-0114.03 and consists of this page 1 and evidence page E-1, as well as approval document mentioned above.

The submitted documentation was reviewed by **Carlos M. Utrera, P.E.**



*[Signature]*  
07/19/2012

**NOA No. 12-0517.24**  
**Expiration Date: February 22, 2016**  
**Approval Date: July 26, 2012**  
**Page 1**

**NOTICE OF ACCEPTANCE: EVIDENCE SUBMITTED**

**A. DRAWINGS**

1. Drawing No. **CMA-D-004**, titled "CMA-D", sheets 1 and 2 of 2, dated 05/22/2000, prepared by the manufacturer, signed and sealed by James D. Wells, Jr., P.E.

**B. TESTS "Submitted under NOA # 11-0114.03"**

1. Test reports on
  - 1) Air Infiltration Test, per FBC, TAS 202-94
  - 2) Uniform Static Air Pressure Test, Loading per FBC TAS 202-94
  - 3) Water Resistance Test, per FBC, TAS 202-94
  - 4) Large Missile Impact Test per FBC, TAS 201-94
  - 5) Cyclic Wind Pressure Loading per FBC, TAS 203-94
  - 6) Forced Entry Test, per FBC 2411 3.2.1, TAS 202-94along with marked-up drawings and installation diagram of CMA-D Polycarbonate Aluminum Fixed Skylights, prepared by National Certified Testing Laboratories, Test Reports No. **210-3716-2**, dated 11/22/2010, with a revision dated 03/07/2010, signed and sealed by Gerard J. Ferrara, P.E.

**C. CALCULATIONS "Submitted under NOA # 11-0114.03"**

1. Anchor calculations prepared by J & L Wells Consulting LLC, dated 01/04/2011, signed and sealed by James D. Wells, Jr., P.E.

**D. QUALITY ASSURANCE**

1. Miami-Dade Department of Permitting, Environment, and Regulatory Affairs (PERA)


**E. MATERIAL CERTIFICATIONS**

1. Notice of Acceptance No. **12-0110.04** issued to Palram Americas, Inc. for their "Corrugated and Flat Polycarbonate Panels", approved on 02/23/2012 and expiring on 01/22/2016.
2. Notice of Acceptance No. **08-0305.02** issued to SABIC Innovative Plastics for their "Lexan Sheet Products" approved on 04/24/2008 and expiring on 07/17/2013.
3. Notice of Acceptance No. **10-0329.03** issued to Sheffield Plastics, Inc., for their "Makrolon Polycarbonate Sheets" approved on 07/07/2010 and expiring on 08/27/2012.

**F. STATEMENTS**

1. Statement letter of code conformance to 2010 FBC issued by J & L Wells Consulting LLC, dated 04/25/2012, signed and sealed by James D. Wells, Jr., P.E.
- "Submitted under NOA # 11-0114.03"**


2. Statement letter of code conformance with FBC 2007 and no financial interest issued by J & L Wells Consulting LLC, dated 03/17/2011, signed and sealed by James D. Wells, Jr., P.E.

  
07/19/2012

Carlos M. Utrera, P.E.  
Product Control Examiner  
NOA No. 12-0517.24  
Expiration Date: February 22, 2016  
Approval Date: July 26, 2012

J & L Wells Consulting LLC  
1453 Arbutus Circle  
Oviedo, FL 32765  
(407) 496-5489  
Certificate of Authorization No. 27162

Engineer of Record:  
James D. Wells, Jr., P.E.  
Professional Engineer No. 53616

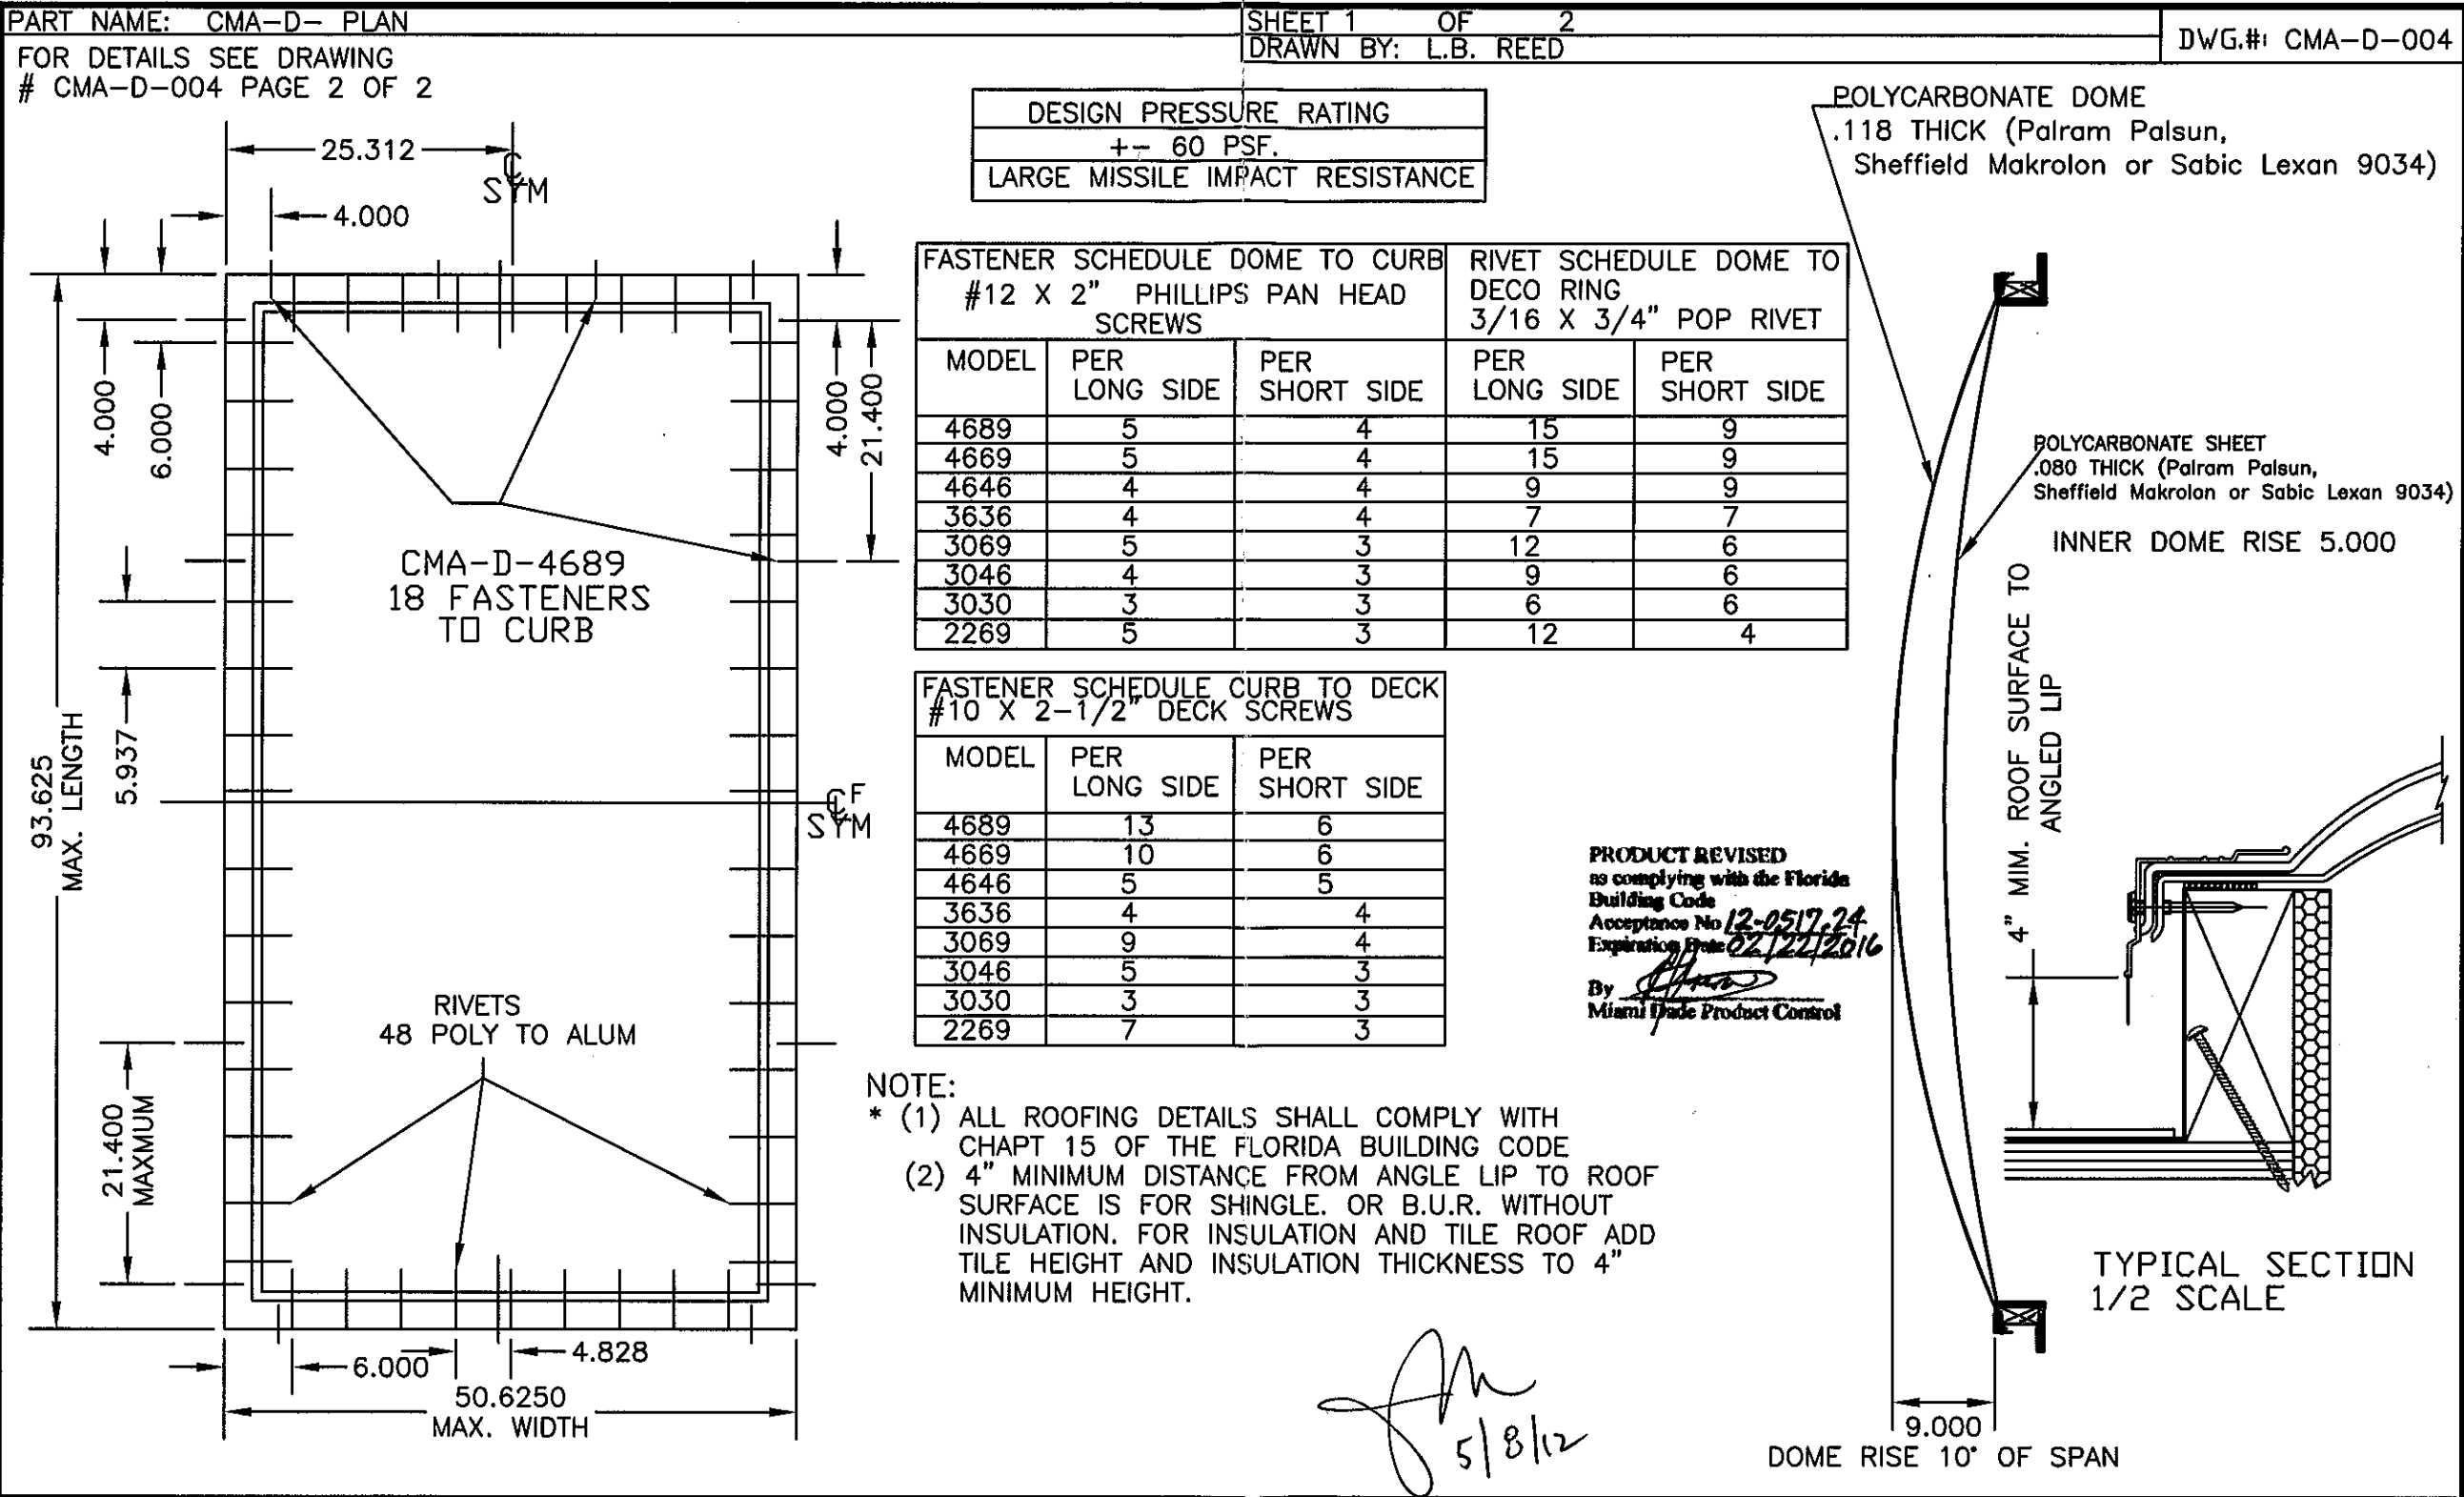

J & L Wells Consulting LLC  
1453 Arbutus Circle  
Oviedo, FL 32765  
(407) 496-5489  
Certificate of Authorization No. 27162

Engineer of Record:  
James D. Wells, Jr., P.E.  
Professional Engineer No. 53616

